

4824

**REMOVAL SITE EVALUATION RADIOLOGICAL
CONTROL UNIT FACILITIES PROJECT
SEPTEMBER 1993**

10/19/93

**DOE-FN/FERMCO
26
RSE**

REMOVAL SITE EVALUATION

RADIOLOGICAL CONTROL UNIT FACILITIES PROJECT

FERNALD ENVIRONMENTAL MANAGEMENT PROJECT

U. S. DEPARTMENT OF ENERGY

SEPTEMBER, 1993

REMOVAL SITE EVALUATION

RADIOLOGICAL CONTROL UNIT FACILITIES PROJECT

INTRODUCTION

The Radiological Control Unit Facilities Project is planned to upgrade change facilities and radiological control points at the FEMP to achieve full compliance with FERMCO's Radiological Controls Manual Implementation Plan. This work will also provide improved contamination and access controls, increased worker efficiency due to reductions in travel time for breaks, minimized waste generation through the use of reusable anti-Cs, and should result in fewer heat related stress incidents.

Control points will be set up at individual contamination compounds to be established in the former process area of the FEMP. These compounds will encompass individual buildings or in some cases groups of buildings. Each compound will be fenced to provide positive ingress and egress control. The compounds will have change facilities, some break areas, and provide controlled access to the radiologically controlled areas. Personnel without the proper level of training or protective clothing will not be able to enter the compound.

Mobile trailers will be used for these change facilities at FEMP locations where buildings or structures are being demolished and involve a substantial number of personnel (including contractors). For buildings with elongated clean-up/demolition schedules and having fewer people working in the area, the change facilities will be portable, modular structures to be placed within the buildings themselves to serve as change facilities/radiological control points.

The specific project scope is comprised of the following items:

- (1) Modular trailer complexes to be initially sited in the approximate locations shown in Figures 1-4 based on the projected schedule of remedial activities. Each complex will be comprised of four modular units which will provide access control points, mens and womens change facilities, restrooms, shower facilities, and a break room. Upon the completion of D&D work in one contamination compound, the use of trailers will allow relocation of change/break facilities to another work area to adequately support cleanup operations elsewhere.
- (2) One single trailer located at Building 8 (Figure 5) to support long term operation of the facility. This will provide access control points and mens and womens change facilities for personnel assigned to ongoing building operations.
- (3) Three portable containment structures to be utilized inside Buildings 5, 6, and 9 for access controls and change facilities in the approximate locations shown in Figures 6-8. A similar structure may also be acquired for Building 78. No running water or break facilities are included with these facilities. The structures will be used to support Safe Shutdown activities at these buildings that are preliminary to D&D activities.

- (4) Installation of approximately 7,100 feet of permanent fencing will be undertaken to provide a barrier for positive access control into the established contamination compounds. Approximately 21 vehicle gates will be required to support the movement and control of equipment supporting project work at each compound.

The following wastes, determined to be non-hazardous by process knowledge, are expected to be generated from this project:

- Soil, gravel, and possible concrete for the installation of trailers, their anchoring devices, along with underground utility tie-ins. While a minimum amount of site preparation work is to be done, the amount of these wastes will depend upon specific details in contractor proposals/bids.
- Other non-soil debris (plastic, paper, rubber, cardboard packaging material; possible anti-Cs and miscellaneous project trash).

For Scope Item (3), no construction wastes will be generated for installation of the inside change facilities other than packaging materials and possible radiologically contaminated anti-Cs, gloves, clothing, etc. because the work will not involve any demolition/modifications of existing FEMP buildings.

This Removal Site Evaluation (RSE) has been completed by the Department of Energy (DOE) under authorities delegated by Executive Order 12580 under Section 104 of CERCLA and is consistent with Section 300.410 of the National Oil and Hazardous Substances Pollution Contingency Plan (NCP). This RSE addresses the project involving all radiological control unit facilities. This RSE has been completed to support the decision as to whether the project conditions warrant a removal action. Controls implemented to support this construction activity are also presented in the RSE to demonstrate that the proposed construction will not cause deterioration of the existing site conditions.

SOURCE TERM

Consistent with 40 CFR 300.410(a), the RSE includes a removal preliminary assessment which is based upon readily available information as described in 40 CFR 300.410(c). A RCRA Determination/Radiological Characterization is underway to evaluate contaminant levels in the soil and debris from this project. Prior sampling in the production area has shown some chemical contamination (e.g. metals, organics) above detectable levels in soil at the FEMP. Soil and gravel disturbed by this project represent a source of possible releases should they contain radiological or chemical contamination.

Areas in which the change facility trailers are to be placed have been characterized for general radiological contamination levels. These areas are primarily gravel covered with direct readings ranging from non-detectable to 1.5 kdp/cm² beta-gamma and 0.2 kdp/cm² alpha and removable contamination levels less than MDA. If the gravel is removed or disturbed, the possibility exists for

exposing removable contamination to the environment and creating a pathway for the spread of contamination. Attachment 2 contains typical radiological surveys for the construction area.

EVALUATION OF THE MAGNITUDE OF THE POTENTIAL THREAT

Based on the above information, uranium and chemical contamination from displaced soil and gravel are the sources of threat in the event of a release. To manage the hazards and prevent the spread of contamination, the following controls, among others, will be implemented during construction of the new facilities.

- Excess soil from this project will be managed according to Removal Action 17 criteria. Soil will be backfilled, stockpiled or containerized in accordance with the management criteria specified in the Removal Action 17 work plan.
- Physical barriers will be positioned around the work area to prevent unauthorized access.
- Protective clothing and respiratory protection will be provided for workers, as required.
- Plastic tarpaulins and bags and appropriate containers will be readily available to contain radiologically contaminated materials, as required.
- Runoff controls will be established, as required.

All activities performed in support of this project will follow applicable site policies and procedures written to control such activities. These procedures include, but are not limited to, the following:

- SSOP-0044, "Management of Soil, Debris, and Waste from a Project"
- SP-P35-010, "Unrestricted Release of Materials from FMPC"
- Removal Action No. 17, "Improved Storage of Soil and Debris"

Excavation will not be allowed without appropriate radiological controls. During the installation of the change facilities, a Radiological Work Permit will be issued and the work area will be surveyed during and upon completion of work. Clean gravel or other suitable material (per Removal Action 17) will be used to cover any area above controlled area limits.

ASSESSMENT OF THE NEED FOR REMOVAL ACTION

Consistent with Section 40 CFR 300.410 of the NCP, the DOE shall determine the appropriateness of a removal action. Eight factors to be considered in this determination are listed in 40 CFR 300.415 (b)(2). Based on the data presented above, the following one of the eight criteria listed in the NCP applies:

- 40 CFR 300.415(b)(2)(v)
Weather conditions that may cause hazardous substances or pollutants or contaminants to migrate or be released

Phase I of Removal Action 17 requires placement on and covering of contaminated soils with a heavy, nonpermeable tarpaulin. The tarpaulins will prevent the spread of contamination and resultant exposure to humans, animals or the food chain.

The potential of a release or migration of hazardous substances from these project sites is negligible. The low levels of contamination at these work sites also support the conclusion that any threat resulting from uranium contamination is negligible. Thus, while the above criteria can be applied to the Radiological Control Unit Facilities Project, it does not constitute the need for a removal action.

APPROPRIATENESS OF A RESPONSE

Based on the evaluation of all the above factors, it has been determined that a removal action will not be necessary and this project should be continued as a planned construction activity in support of the CERCLA remediation process at the FEMP. Furthermore, the controls planned in conjunction with this construction activity and management procedures established in accordance with Removal Action 17 are adequate to mitigate any hazards to human health, safety, and the environment and to prevent deterioration of existing site conditions.

4824

ATTACHMENT 1

LOCATIONS OF CHANGE TRAILERS AND FENCING

0006

4824

BUILDING 4A

SNOW FENCE

BUILDING 4C

BUILDING 4B

RAD CONTROL BOUNDARY
"CONCRETE BARRIERS"

PLANT 7

B STREET

NORTH

C STREET

EQUIPMENT
ACCESS
EGRESS
POINT

DELON
TRAILER
COMPLE

DIRTY
ROAD
EXIT
POINT

ENTRANCE
EXIT
CLEAR
SIDE

1ST STREET

PLANT 7

0007


EXISTING
FENCE REMOVED
BY SUBCONTRACTOR

RAD CONTROL BOUNDARY
"SNOW FENCE" 2 FEET OF EDGE OF ROAD

43' WIDE


135' LONG

EDGE OF BLACKTOP ROAD

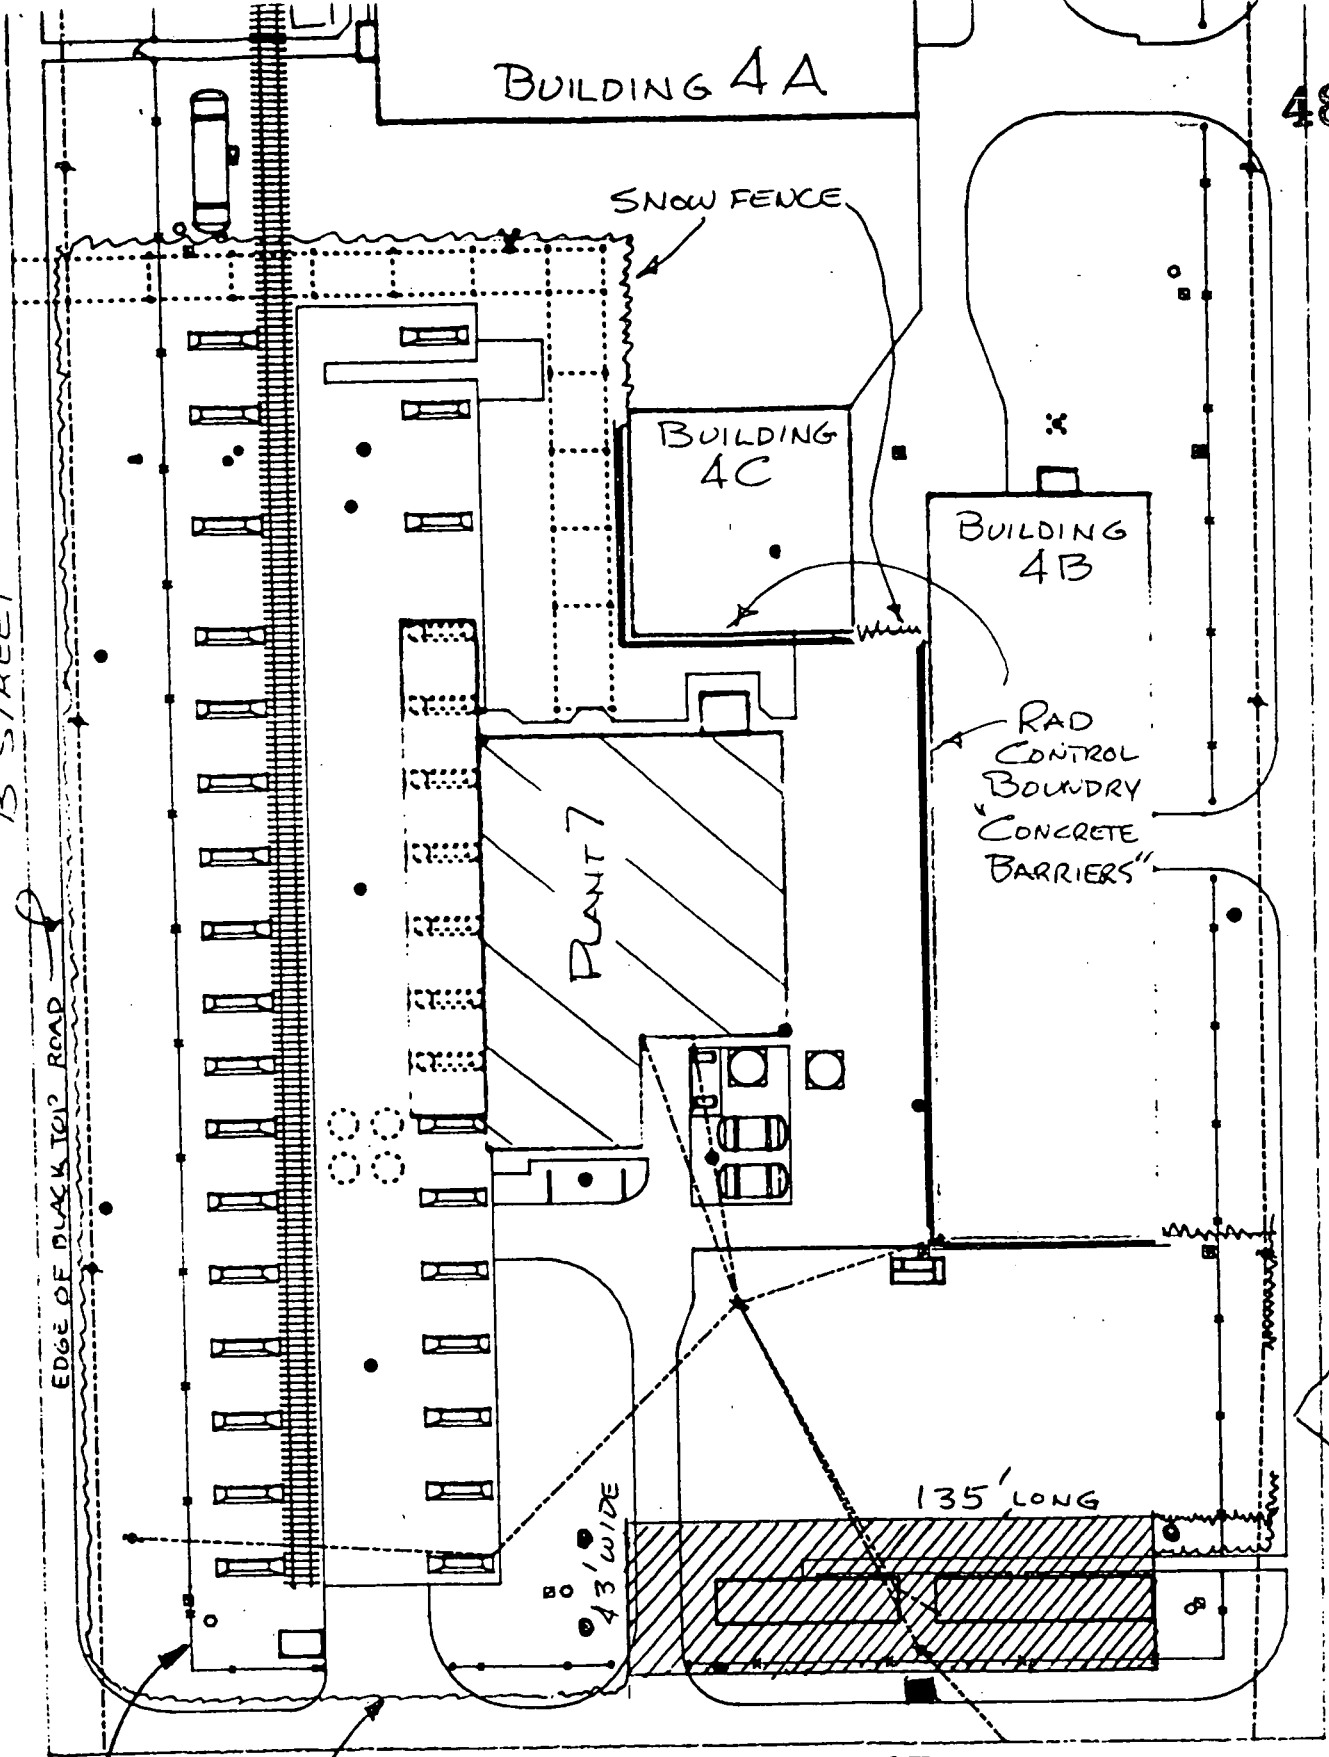



N↑

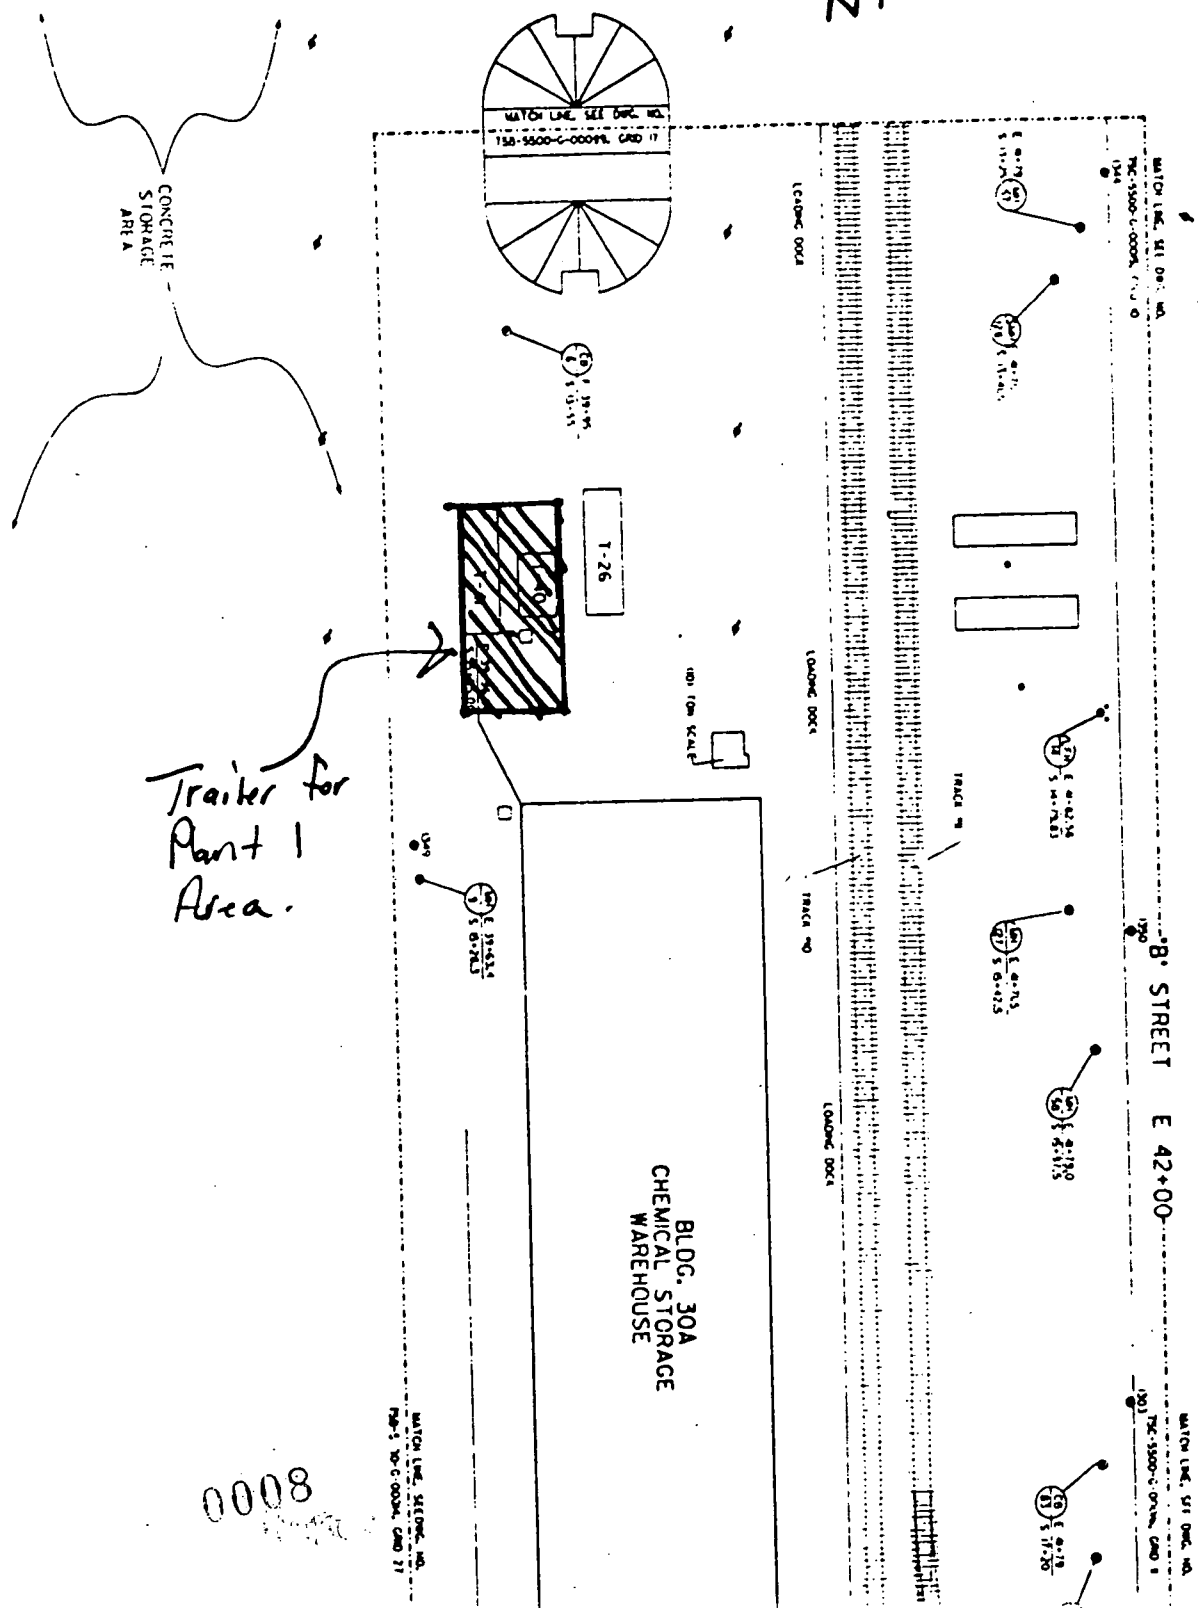

0008


FIGURE 3


4824

Track
for
plant


N ↑

PLANT 4

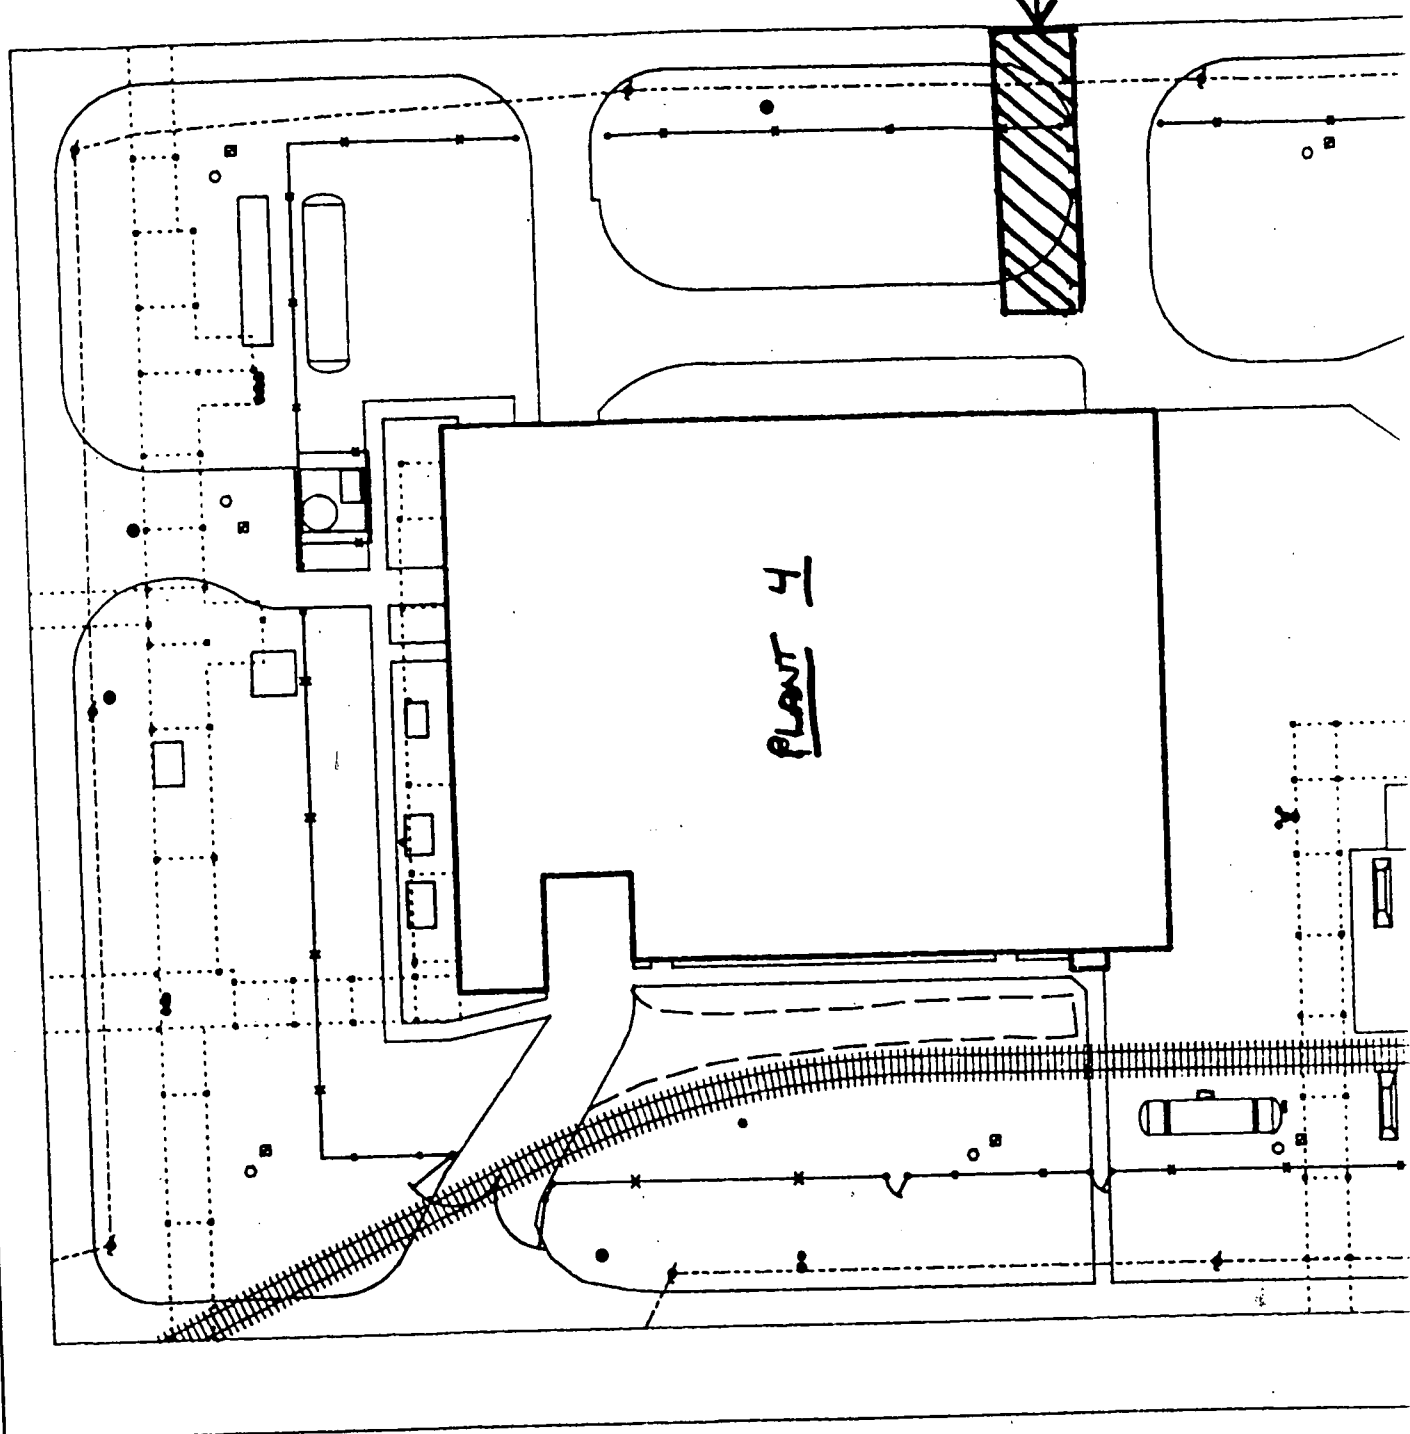

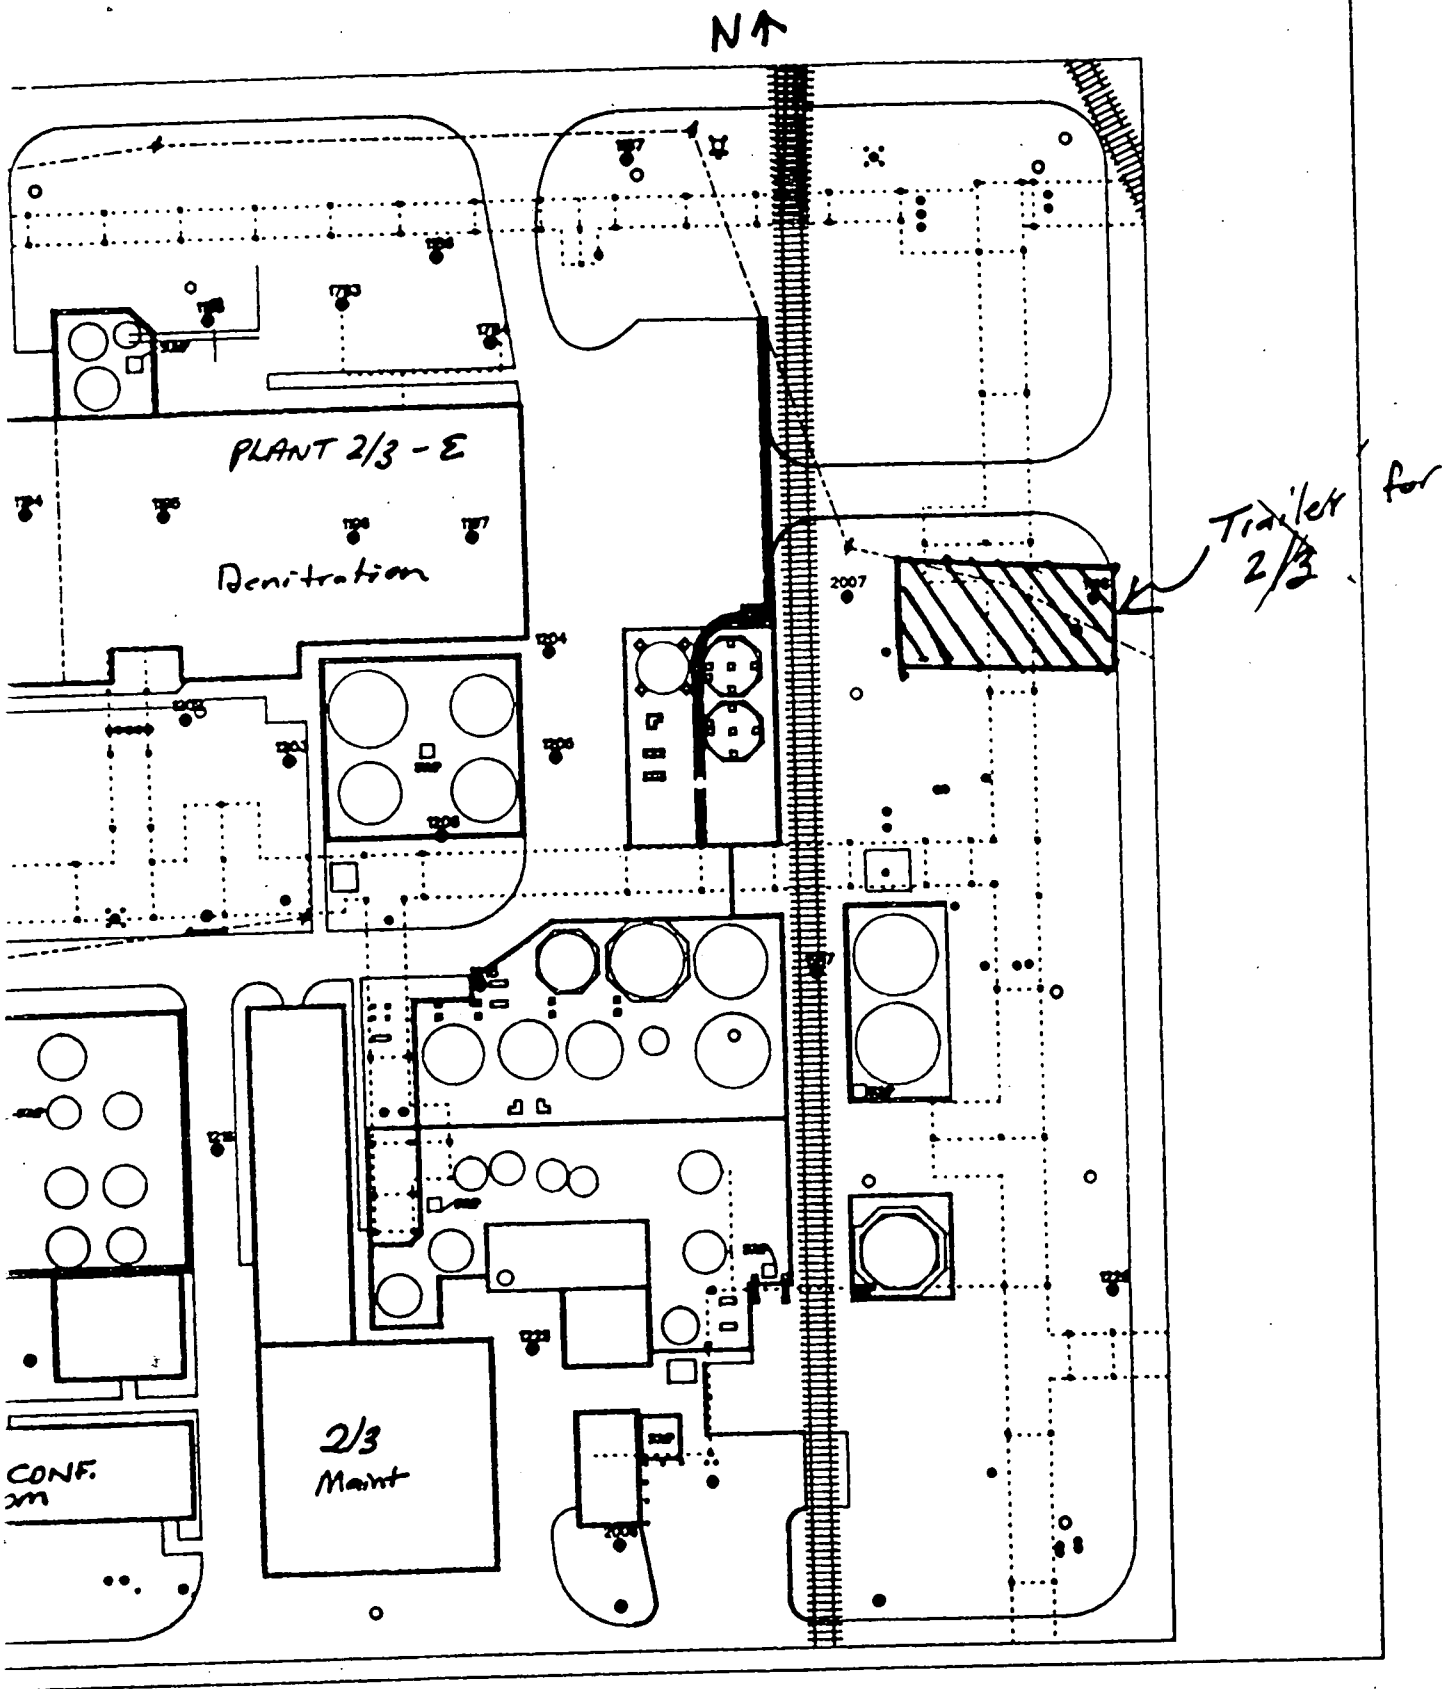

N ↑

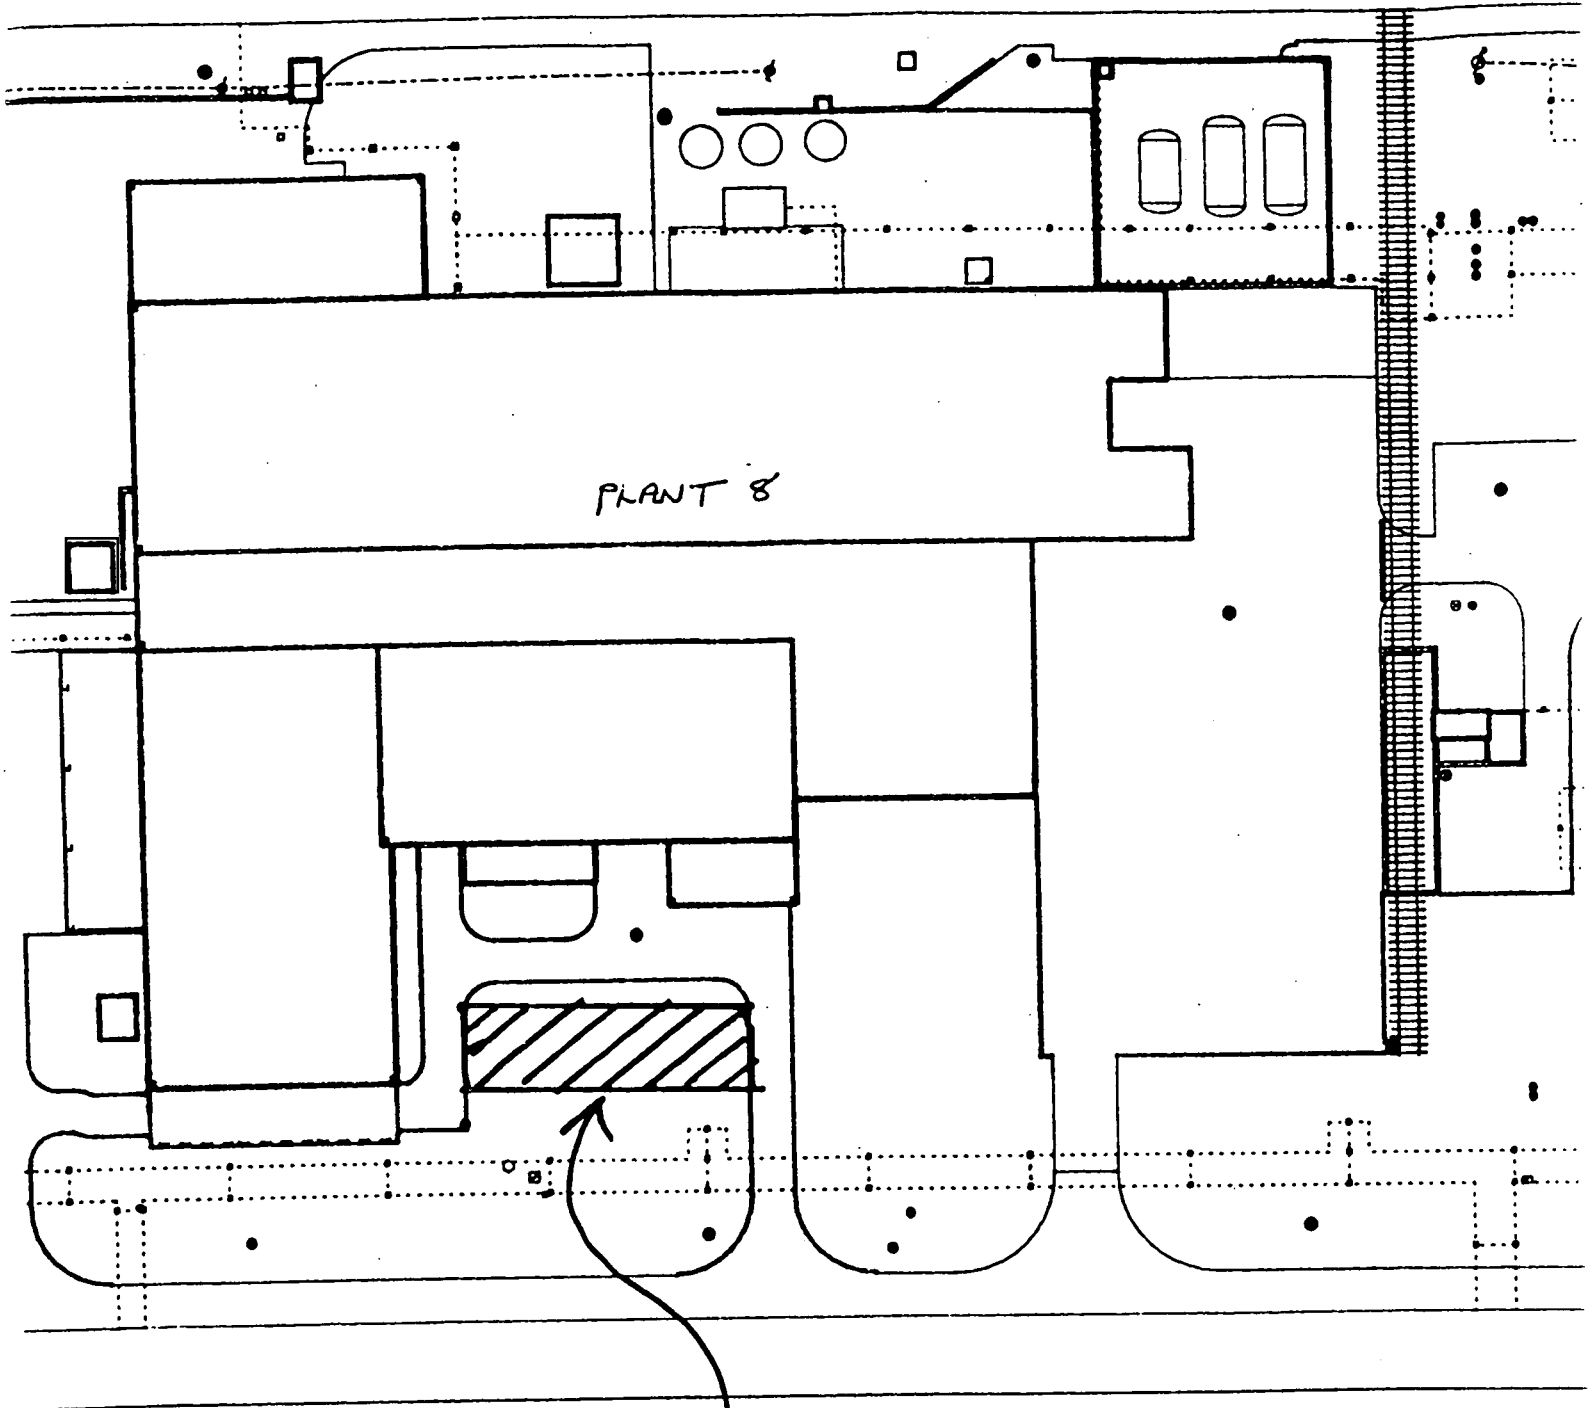

PLANT 8


PLANT 8 Trailer

0011

2500

FIGURE 6

LOCATION OF INTERIOR CHANGE FACILITIES FOR PLANT 5

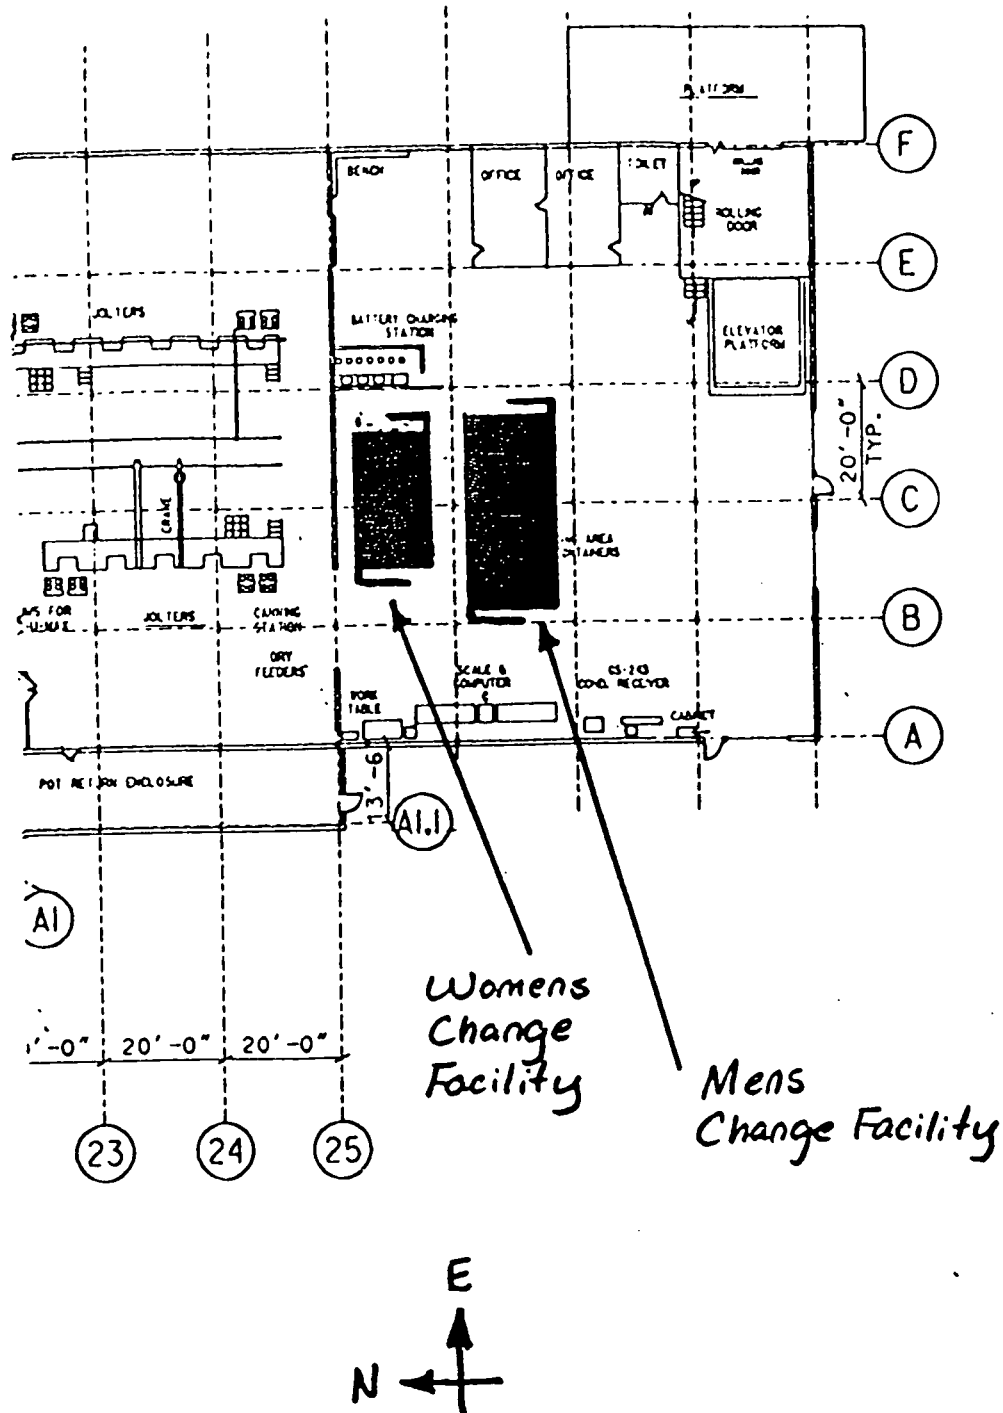

0012

ENVIRONMENTAL
MT CO. OF OHIO
ALD, OHIO




PLANT 5

FIRST FLOOR
METALS PRODUCTION PLANT
FLOOR PLAN

FIGURE 7

LOCATION OF INTERIOR CHANGE FACILITIES FOR PLANT 6

4824

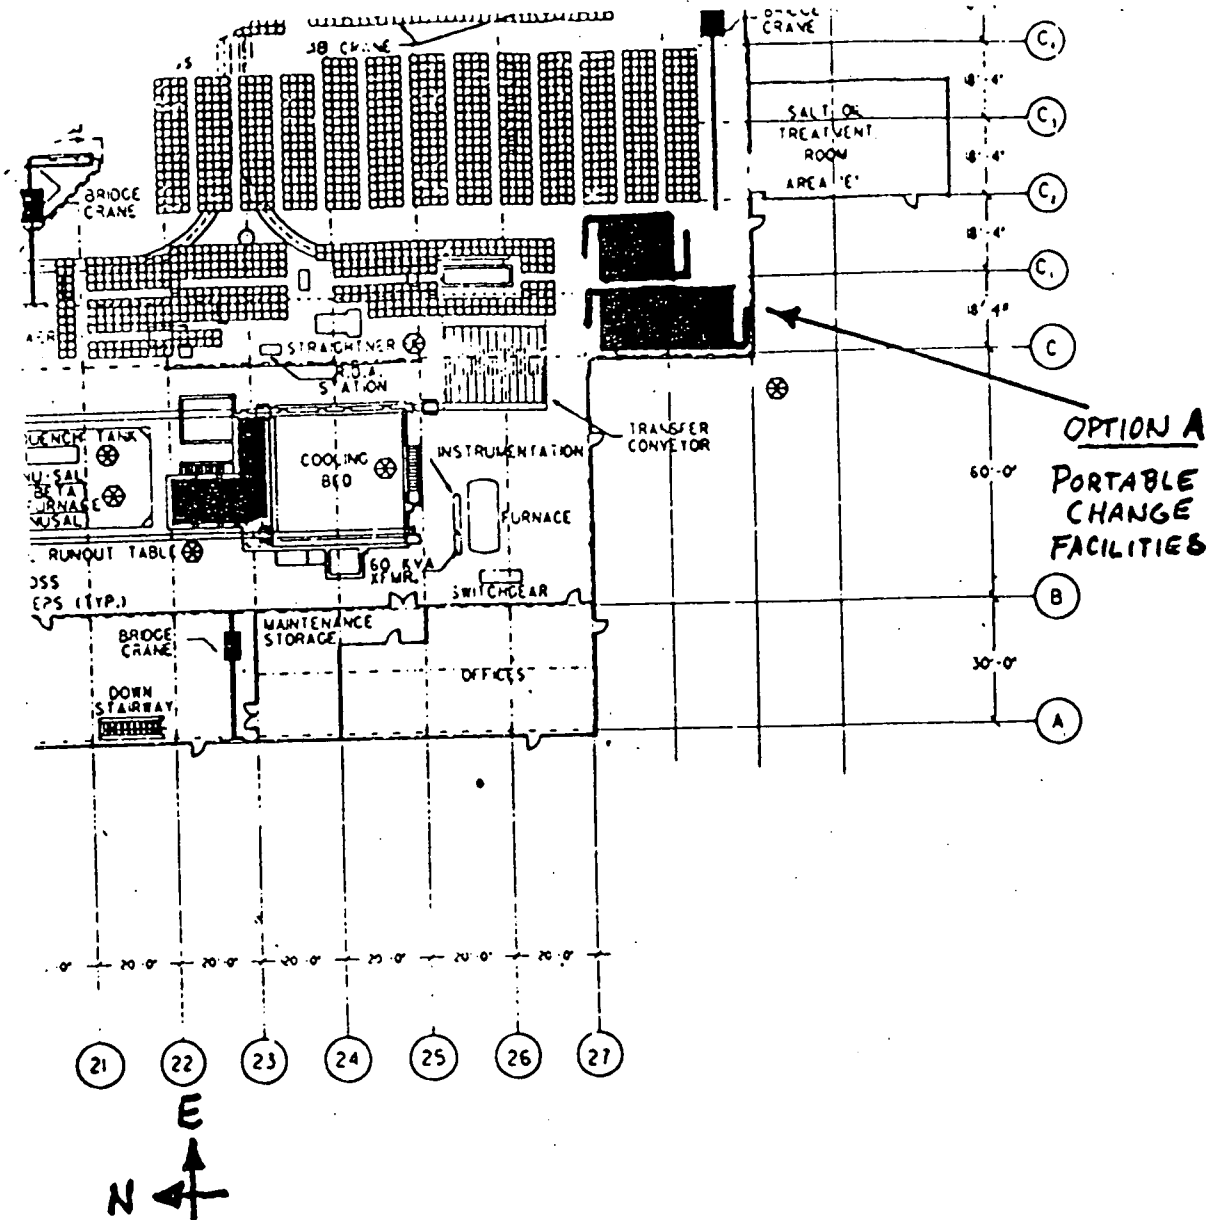


APPROVALS				PLANT 6 FIRST FL	
		J.A.S. & T.		METALS FABRICATION PLANT	
		MAINTENANCE		EQUIPMENT LAYOUT	
		SAFETY		SCALE 1"=20'	
		O.A.			
		PRODUCTION			
		FIRE & SAFETY			
		WASTE WAREHOUSE			
		O.B.E.			
		SECURITY			
				REV. NO.	06X-5500-A-08149
				DATE	Rev. A 7/92
				Drawn	JPD
				FILE NAME: server\floor\6.DGN	

0013

4824

FIGURE 8

LOCATION OF INTERIOR CHANGE FACILITIES FOR PLANT 9

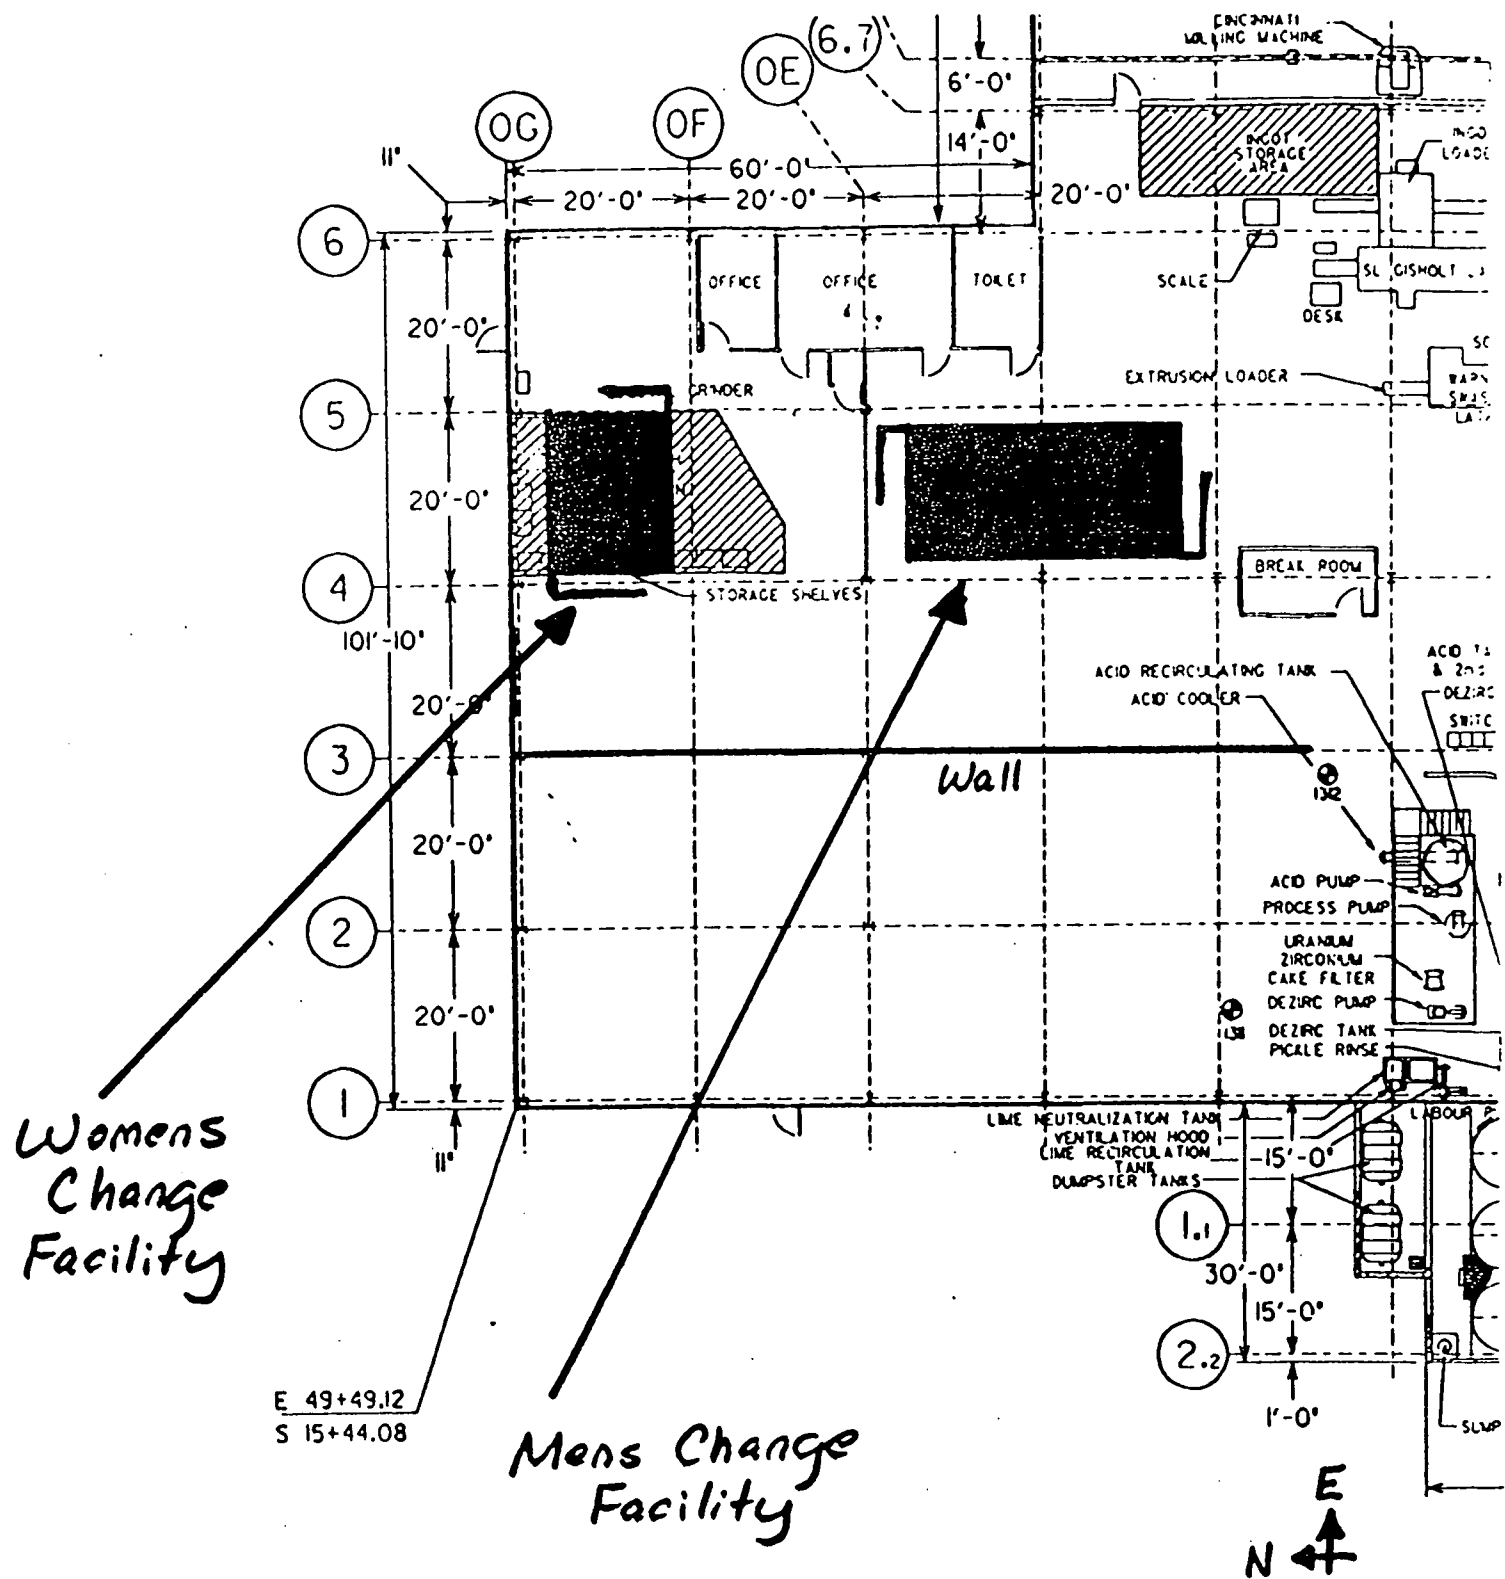


FLOOR PLAN EL.15

0014

GRID 13 OUTDOOR AREAS REFERENCE MAP

4824

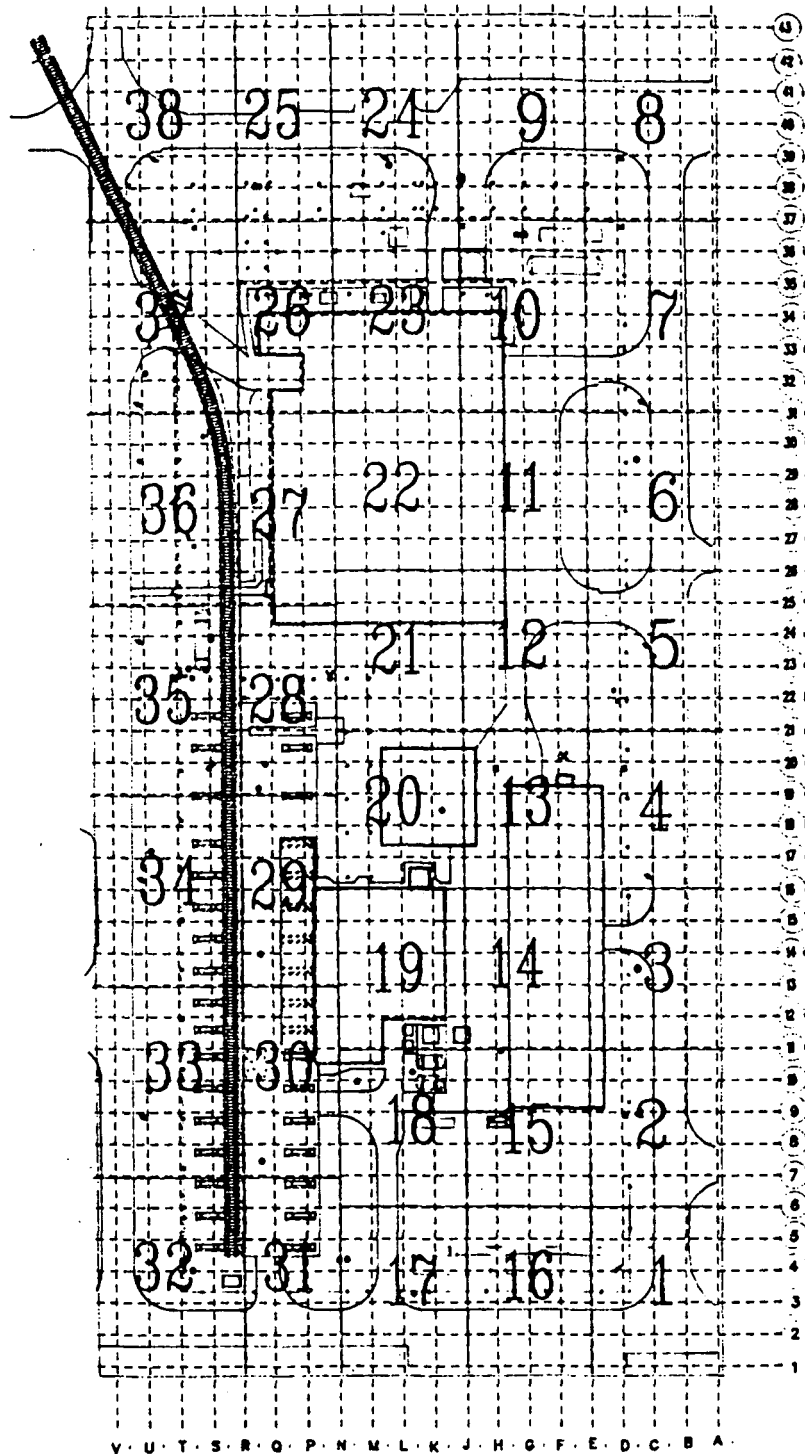

001511

4824

ATTACHMENT 2
RADIOLOGICAL SURVEY RESULTS

0016

FMPC
INDUSTRIAL, RADIOLOGICAL SAFETY & TRAINING - RADIOLOGICAL SAFETY
RADIOLOGICAL SURVEY REPORT

4824

Date: 9-24-91	LOCATION: GRID 13, outdoors	RST: Linda May	Page 1 of 4
Time: 8:00 AM	LEVEL: 580'	Reslie A. Powell	

REASON FOR SURVEY: ☐ ROUTINE ☒ SPECIAL REQUEST ☐ RWP ☐ INCIDENT

COMMENTS: Process Area Characterization of gravel, exterior bldg. surfaces, roadways, etc. in Grid 13. Map #17 MDA $\alpha = 220$ BX = 400	<table border="1" style="width: 100%; border-collapse: collapse;"> <tr> <th colspan="5">INSTRUMENTS</th> </tr> <tr> <th>MODEL</th> <th>SERIAL NUMBER</th> <th>CALIBRATION DATE</th> <th>BKRD.</th> <th>EFF.</th> </tr> <tr> <td>3BX</td> <td>77119</td> <td>2-92</td> <td>250cpm</td> <td>.1</td> </tr> <tr> <td>32</td> <td>77143</td> <td>2-92</td> <td>0</td> <td>.1</td> </tr> <tr> <td>3BX/32</td> <td>77119/77143</td> <td>2-92/2-92</td> <td>60%</td> <td>.25/.09</td> </tr> </table> <p>ANALYZE FOR: <input checked="" type="checkbox"/> ALPHA <input checked="" type="checkbox"/> BETA-GAMMA <input type="checkbox"/> OTHER</p> <p>TYPE OF SURVEY: <input checked="" type="checkbox"/> CONTAMINATION <input type="checkbox"/> RADIATION <input type="checkbox"/> OTHER</p>	INSTRUMENTS					MODEL	SERIAL NUMBER	CALIBRATION DATE	BKRD.	EFF.	3BX	77119	2-92	250cpm	.1	32	77143	2-92	0	.1	3BX/32	77119/77143	2-92/2-92	60%	.25/.09
INSTRUMENTS																										
MODEL	SERIAL NUMBER	CALIBRATION DATE	BKRD.	EFF.																						
3BX	77119	2-92	250cpm	.1																						
32	77143	2-92	0	.1																						
3BX/32	77119/77143	2-92/2-92	60%	.25/.09																						

FOLLOW-UP SURVEY ATTACHED ☐ YES ☒ NO
 SURVEY MAP ATTACHED ☒ YES ☐ NO

ITEM NUMBER	GRID COORDINATES	DESCRIPTION	CORRECTED DOSE RATE (mRem/hr)				DPM ALPHA		DPM BETA-GAMMA	
			γ	β/γ	γ	β/γ	100 CM ²	PROBE	100 CM ²	PROBE
			CONTACT	CONTACT	3 FT.	3 FT.				
1		GRAVEL						<200		<1K
2		"						<200		<1K
3		CONCRETE						<200		<1K
4		"						<200		<1K
5		GRAVEL						<200		<1K
6		↓						<200		<1K
7								<200		<1K
8								<200		<1K
9								<200		<1K
10								<200		<1K
11								<200		<1K
12		↓						<200		<1K
13		TAR ON CONCRETE						<200		<1K
14		CONCRETE						<200		<1K
15		GRAVEL						<200		<1K
16		"						<200		<1K

DISTRIBUTION OF COPIES	
1	Radiological Safety Technician Supervisor
2	Radiological Safety Engineer
3	Facility Supervisor

NOTIFICATION OF SURVEY RESULTS					
SUPERVISOR NOTIFIED	TIME	DATE	NOTIFIED BY	REVIEWED BY	DATE
					0017

GRID 13 outdoors Map #17

2 of 4

9/24/91

4824

FMPC

INDUSTRIAL, RADIOLOGICAL SAFETY & TRAINING - RADIOLOGICAL SAFETY

8:00 AM

RADIOLOGICAL SURVEY REPORT (CONTINUATION SHEET)

ITEM NUMBER	GRID COORDINATES	DESCRIPTION	CORRECTED DOSE RATE (mRem/hr)				DPM ALPHA		DPM BETA-GAMMA	
			γ	β/γ	γ	β/γ	100 CM ²	PROBE	100 CM ²	PROBE
			CONTACT	CONTACT	3 FT.	3 FT.				
17		GRAVEL						600		<1K
18		"						600		<1K
19		CONCRETE						600		<1K
20		"						600		<1K
21		GRAVEL						600		<1K
22		↓						600		<1K
23		↓						600		<1K
24		WOODEN RAIL						600		<1K
25		WOODEN WALKWAY						600		<1K
26		TRAILER WALL 5' up						600		<1K
27		WOODEN RAIL						600		<1K
28		STEPS						600		<1K
29		TRAILER WALL 2' up						600		<1K
30		" " 3' up						600		<1K
31		RUBBER WALKWAY						600		<1K
32		" "						600		<1K
33		CONCRETE						600		<1K
34		"						600		<1K
35		GRAVEL						600		<1K
*36		ELECTRIC MANHOLE						4MDA 400	4MDA	4.5K
37		SEAM IN CONCRETE						600		<1K
*38		TELEPHONE MANHOLE						4MDA 1.5K	4MDA	4.5K
39		GRAVEL						600		<1K
40		↓						600		<1K
41		↓						600		<1K
42		CONCRETE						600		<1K
43		"						600		<1K

GRID 13, OUTDOORS Map #17

9/24/91

8:00 AM

FMPC

INDUSTRIAL, RADIOLOGICAL SAFETY & TRAINING - RADIOLOGICAL SAFETY

RADIOLOGICAL SURVEY REPORT (CONTINUATION SHEET)

3 of 4

4824

ITEM NUMBER	GRID COORDINATES	DESCRIPTION	CORRECTED DOSE RATE (mRem/hr)				DPM ALPHA		DPM BETA-GAMMA	
			γ	β/γ	γ	β/γ	100 CM ²	PROBE	100 CM ²	PROBE
			CONTACT	CONTACT	3 FT.	3 FT.				
44		GRAVEL						<200		<1K
45		Trailer Wall 3'up						<200		<1K
46		GRAVEL						<200		<1K
47		"						<200		<1K
48		Trailer Hitch						<200		<1K
49		Trailer Wall 2'up						<200		<1K
50		GRAVEL						<200		<1K
*51		FENCE 2'up						<MDA 300	<MDA	<1K
52		Trailer Wall 3'up						<200		<1K
53		GRAVEL						<200		<1K
54		FENCE 3'up						<200		<1K
55		" 2'up						<200		<1K
56		GRAVEL						<200		<1K
57		Trailer Wall 2'up						<200		<1K
*58		" " "						<MDA 400	<MDA	<1K
59		GRAVEL						<200		<1K
60		FENCE 3'up						<200		<1K
61		Post going across FENCE						<200		<1K
62		GRAVEL						<200		<1K
63		ASPHALT						<200		<1K
64		CONCRETE						<200		<1K
65		GRAVEL						<200		<1K
66		FENCE 3'up						<200		<1K
67		" "						<200		<1K
68		GRAVEL						<200		<1K
69		"					0019	<200		<1K
70		"						<200		<1K

4 of 4

4824

FMPC

INDUSTRIAL RADIOLOGICAL SAFETY & TRAINING - RADIOLOGICAL SAFETY

8:00 AM

RADIOLOGICAL SURVEY REPORT (CONTINUATION SHEET)[illegible]


~~0020~~

OUTDOOR AREAS



4824

All areas characterized on this map are regulated areas unless otherwise noted.

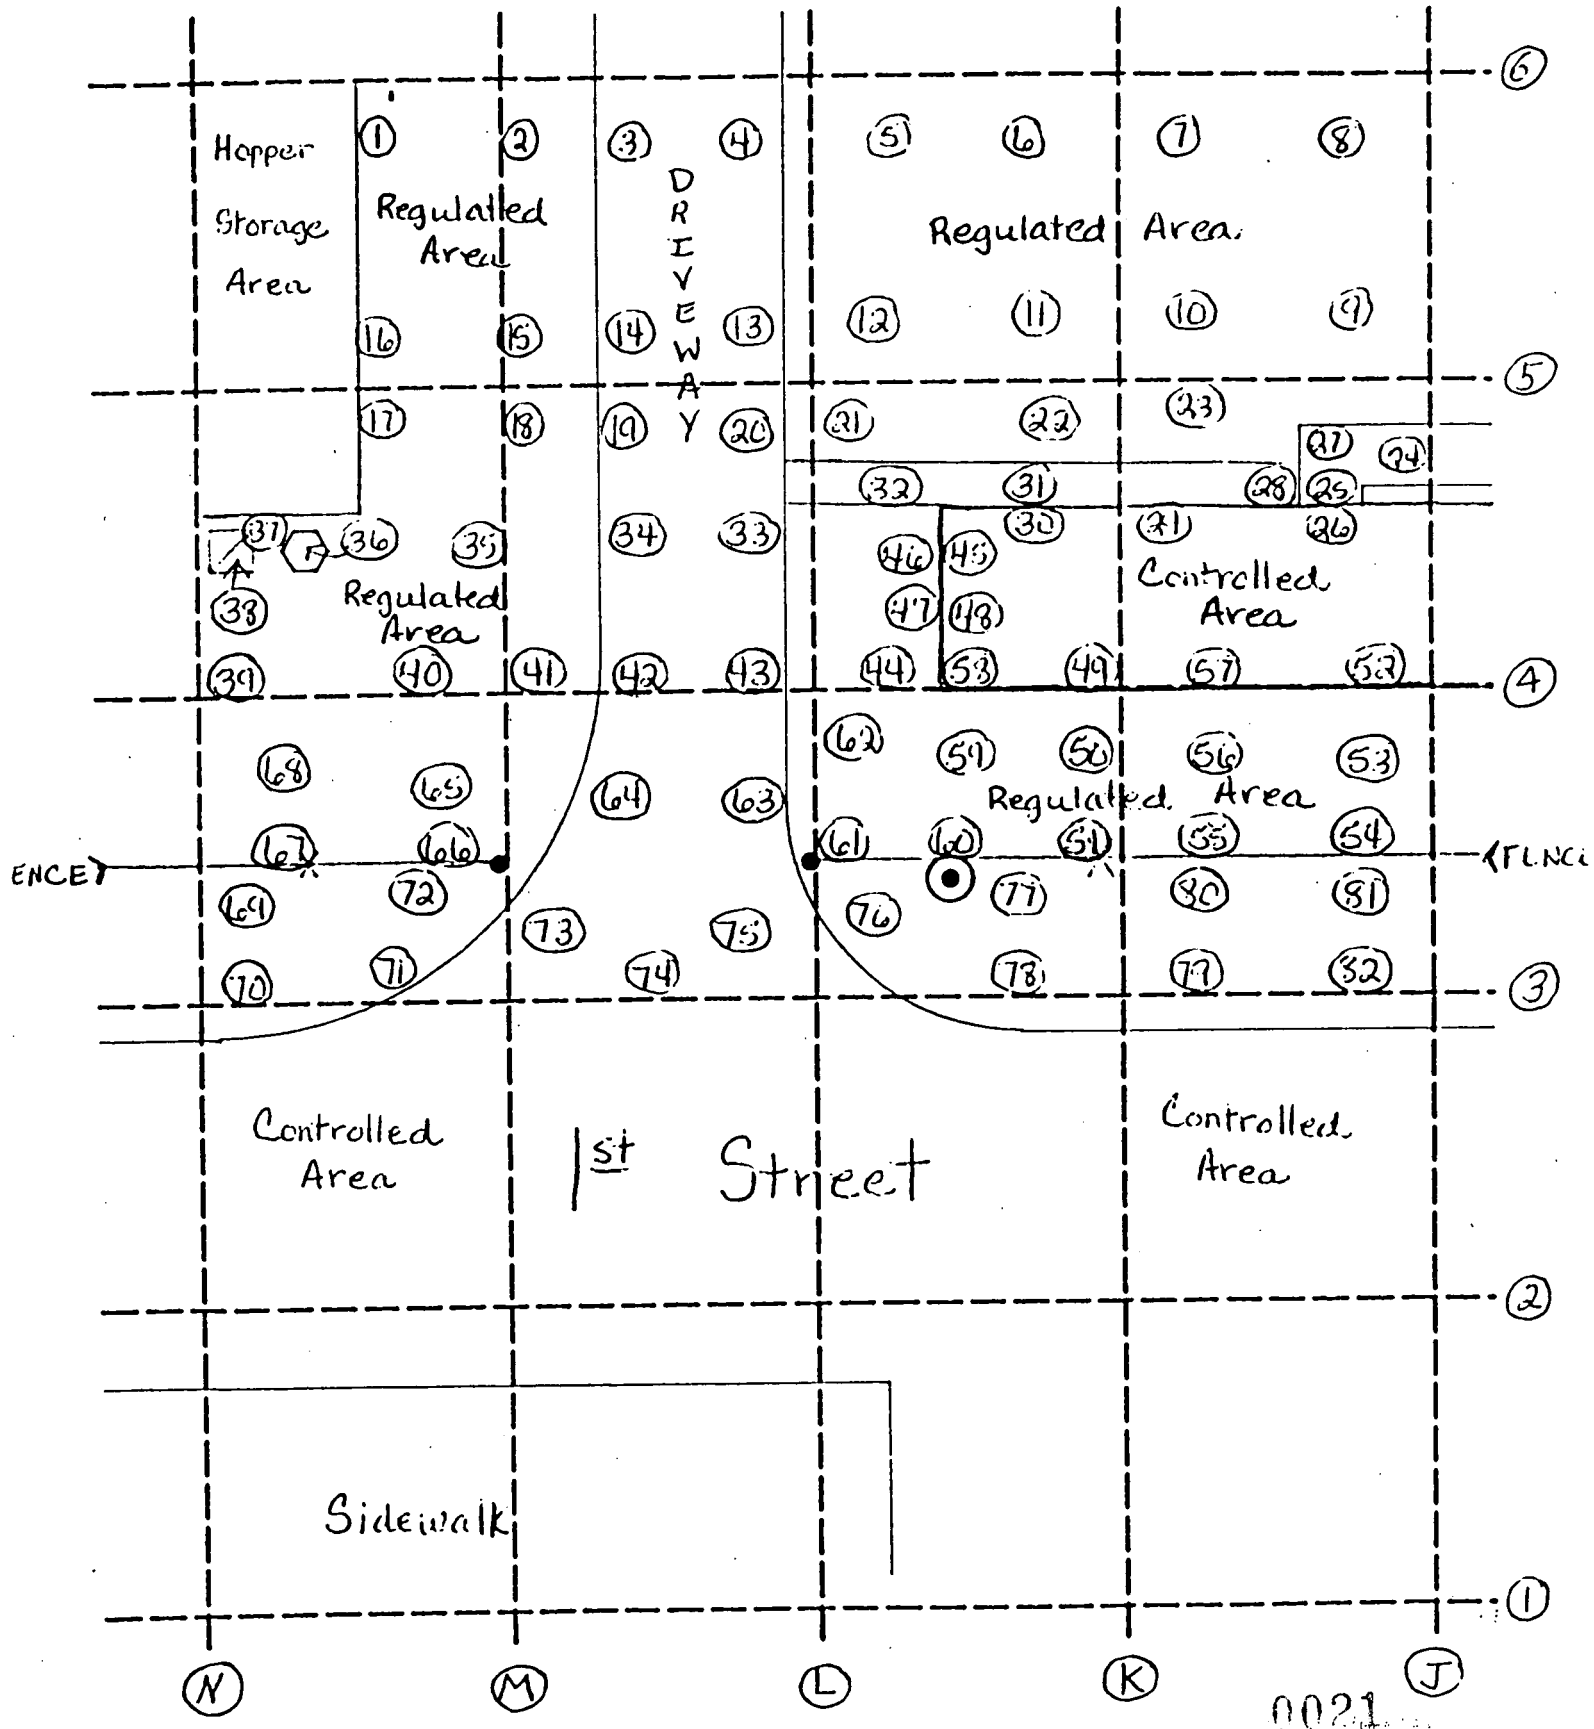

4892-4

FMPO

INDUSTRIAL, RADIOLOGICAL SAFETY & TRAINING - RADIOLOGICAL SAFETY

RADIOLOGICAL SURVEY REPORT

Date: 9.24.91

LOCATION: Grid #13, outdoors

RST: G. Stephens #6148

Page 1 of 7

Time: 09:00

LEVEL: 580'

Chris Havens #6263

REASON FOR SURVEY:

☐ ROUTINE☒ SPECIAL REQUEST☐ RWP☐ INCIDENT

COMMENTS:

Process Area Characterization of
Map #16. NAIS = Not Able to Determine.

ND = none determined.

See pg. 7 for smear counting info.

FOLLOW-UP SURVEY ATTACHED

☐ YES ☒ NO

SURVEY MAP ATTACHED

☒ YES ☐ NO

INSTRUMENTS

MODEL	SERIAL NUMBER	CALIBRATION DATE	BKRD.	EFF.
*Ludlum #3	44209	9.91	0	0.1
32 Ludlum #3	77178	10.91	20 + 2300	0.1

ANALYZE FOR:

☒ ALPHA☒ BETA-GAMMA☐ OTHER

TYPE OF SURVEY:

☒ CONTAMINATION☐ RADIATION☐ OTHER

ITEM NUMBER	GRID COORDINATES	DESCRIPTION	CORRECTED DOSE RATE (mRem/hr)				DPM ALPHA		DPM BETA-GAMMA		
			γ	B/y	γ	B/y	100 CM ²	PROBE	100 CM ²	PROBE	
			CONTACT	CONTACT	3 FT.	3 FT.					
1		Gravel Area						ND		ND	
2								ND		ND	
3								ND		ND	
4								ND		ND	
5								ND		ND	
6								ND		ND	
7								ND		ND	
8								ND		ND	
9								ND		ND	
10								ND		ND	
11								ND		ND	
12								ND		ND	
13								ND		ND	
14								ND		ND	
15								ND		ND	
16								ND		ND	

NOTIFICATION OF SURVEY RESULTS

NO.	DISTRIBUTION OF COPIES
1	Radiological Safety Technician Supervisor
2	Radiological Safety Engineer
3	Facility Supervisor

SUPERVISOR NOTIFIED	TIME	DATE	NOTIFIED BY	REVIEWED BY	DATE

482944.91

24. 2 of 7

INDUSTRIAL, RADIOLOGICAL SAFETY & TRAINING - RADIOLOGICAL SAFETY

RADIOLOGICAL SURVEY REPORT (CONTINUATION SHEET)

ITEM NUMBER	GRID COORDINATES	DESCRIPTION	CORRECTED DOSE RATE (mRem/hr)				DPM ALPHA		DPM BETA-GAMMA	
			γ	β/γ	γ	β/γ	100 CM ²	PROBE	100 CM ²	PROBE
			CONTACT	CONTACT	3 FT.	3 FT.				
17		Gravel Area						N/D		N/D
18								N/D		N/D
19								N/D		N/D
20								N/D		N/D
21								N/D		N/D
22								N/D		N/D
23								N/D		N/D
24								N/D		N/D
25								N/D		N/D
26								N/D		N/D
27								N/D		N/D
28								N/D		N/D
29								N/D		N/D
30								N/D		N/D
31								N/D		N/D
32								N/D		N/D
33								N/D		N/D
34								N/D		N/D
35								N/D		N/D
36								N/D		N/D
37								N/D		N/D
38								N/D		N/D
39								N/D		N/D
40								N/D		N/D
41								N/D		N/D
42								N/D		N/D
43								N/D		N/D

3, f 7

[illegible]

FMPC

INDUSTRIAL, RADIOLOGICAL SAFETY & TRAINING - RADIOLOGICAL SAFETY

RADIOLOGICAL SURVEY REPORT (CONTINUATION SHEET)

ITEM NUMBER	GRID COORDINATES	DESCRIPTION	CORRECTED DOSE RATE (mRem/hr)				DPM ALPHA		DPM BETA-GAMMA	
			γ	B/ γ	γ	B/ γ	100 CM ²	PROBE	100 CM ²	PROBE
			CONTACT	CONTACT	3 FT.	3 FT.				
71		Gravel						ND		ND
72								ND		ND
73								ND		ND
74								ND		ND
75								ND		ND
76								ND		ND
77								ND		ND
78								ND		1.2k
79								ND		<1k
80								ND		ND
81								ND		ND
82								ND		<1k
83								ND		ND
84								ND		ND
85								ND		ND
86								ND		<1k
87								0.2k		1.5k
88								ND		ND
89								ND		<1k
90								ND		ND
91								ND		ND
92								ND		<1k
93		Trail wall 1.2m. x 3						ND		ND
94								ND		ND
95								ND		ND
96								ND		ND
97								ND		ND

4824

Grid 13, Outdoors
Process Area, Map 16
9.25.91

FMPC
INDUSTRIAL RADIOLOGICAL SAFETY & TRAINING - RADIOLOGICAL SAFETY
RADIOLOGICAL SURVEY REPORT (CONTINUATION SHEET)

5 of 7

ITEM NUMBER	GRID COORDINATES	DESCRIPTION	CORRECTED DOSE RATE (mRem/hr)				DPM ALPHA		DPM BETA-GAMMA	
			γ	β/γ	γ	β/γ	100 CM ²	PROBE	100 CM ²	PROBE
			CONTACT	CONTACT	3 FT.	3 FT.				
98		Grey - white band 1.5m						ND		ND
99		Grey - white band 1.5m						0.2K		ND
100		Wall, 1.2 m up						ND		ND
101		Wall, 1 m up						ND		ND
102		"						ND		ND
103		Wall, 1.2 m up						ND		ND
104		Wall, 1 m up						ND		ND
105		Warden walking (www)						ND		ND
106		Log at East door						ND		ND
107		www						ND		ND
108		Hand rail						ND		ND
109		www						ND		ND
110		Hand Rail						ND		ND
111		Wall 1 m up						MDA 0.2K	MDA	ND
112								MDA 0.2K	MDA	ND
113								MDA 0.2K	MDA	ND
114								0.2K		ND
115								ND		ND
116								ND		ND
117		Trailer Hitch						MDA	ND	MDA
118		Wall 1 m up						0.2K		ND
119								0.2K		ND
120								ND		ND
121								ND		ND
122								0.2K		ND
123								MDA 0.3K	MDA	ND
124	0026							MDA 0.3K	MDA	ND

Process Area. Map 10

4.25.41

FMPC

INDUSTRIAL, RADIOLOGICAL SAFETY & TRAINING - RADIOLOGICAL SAFETY.

RADIOLOGICAL SURVEY REPORT (CONTINUATION SHEET)

4824

RADIOLOGICAL SURVEY REPORT (CONTINUED)										
ITEM NUMBER	GRID COORDINATES	DESCRIPTION	CORRECTED DOSE RATE (mRem/hr)				DPM ALPHA		DPM BETA-GAMMA	
			γ	β/γ	γ	β/γ	100 CM ²	PROBE	100 CM ²	PROBE
			CONTACT	CONTACT	3 FT.	3 FT.				
125		W.W.W						ND		ND
126		"						ND		41K
127		"						ND		ND
128		Hard Rail						ND		ND
129		W.W.W						ND		ND
130		force post						6 MDA	.6K	6 MDA 2K
131		force wire						6 MDA	4.2K	6 MDA 1K
132		force post						6 MDA	.2K	6 MDA 3.5K
133		force wire							4.2K	1.8K
134		force post						6 MDA	1.2K	6 MDA 3.5K
135		force wire							4.2K	41K
136		force post						6 MDA	1K	6 MDA 3.5K
137		force wire							ND	41K
138		force post						6 MDA	2K	6 MDA 2.5K
139		concrete force post base						6 MDA	.5K	6 MDA 21K
140		force wire							ND	ND
141		force post						6 MDA	1K	6 MDA 2K
142		concrete base						4.2K	ND	6 MDA 19K
143		force wire							ND	ND
144		force post						6 MDA 4.2K	.8K	6 MDA 2K
145		concrete base						6 MDA	.5K	6 MDA 9K
146		Gravel							ND	ND
147									ND	ND
148									ND	ND
149									ND	ND
150								6 MDA	ND	ND
151									ND	ND

GRID 13, MAP # 116

4824

OUTDOOR AREAS 9-25-91

